



FOR CONTINUATION
REFER TO DRAWING
2092-7-C200

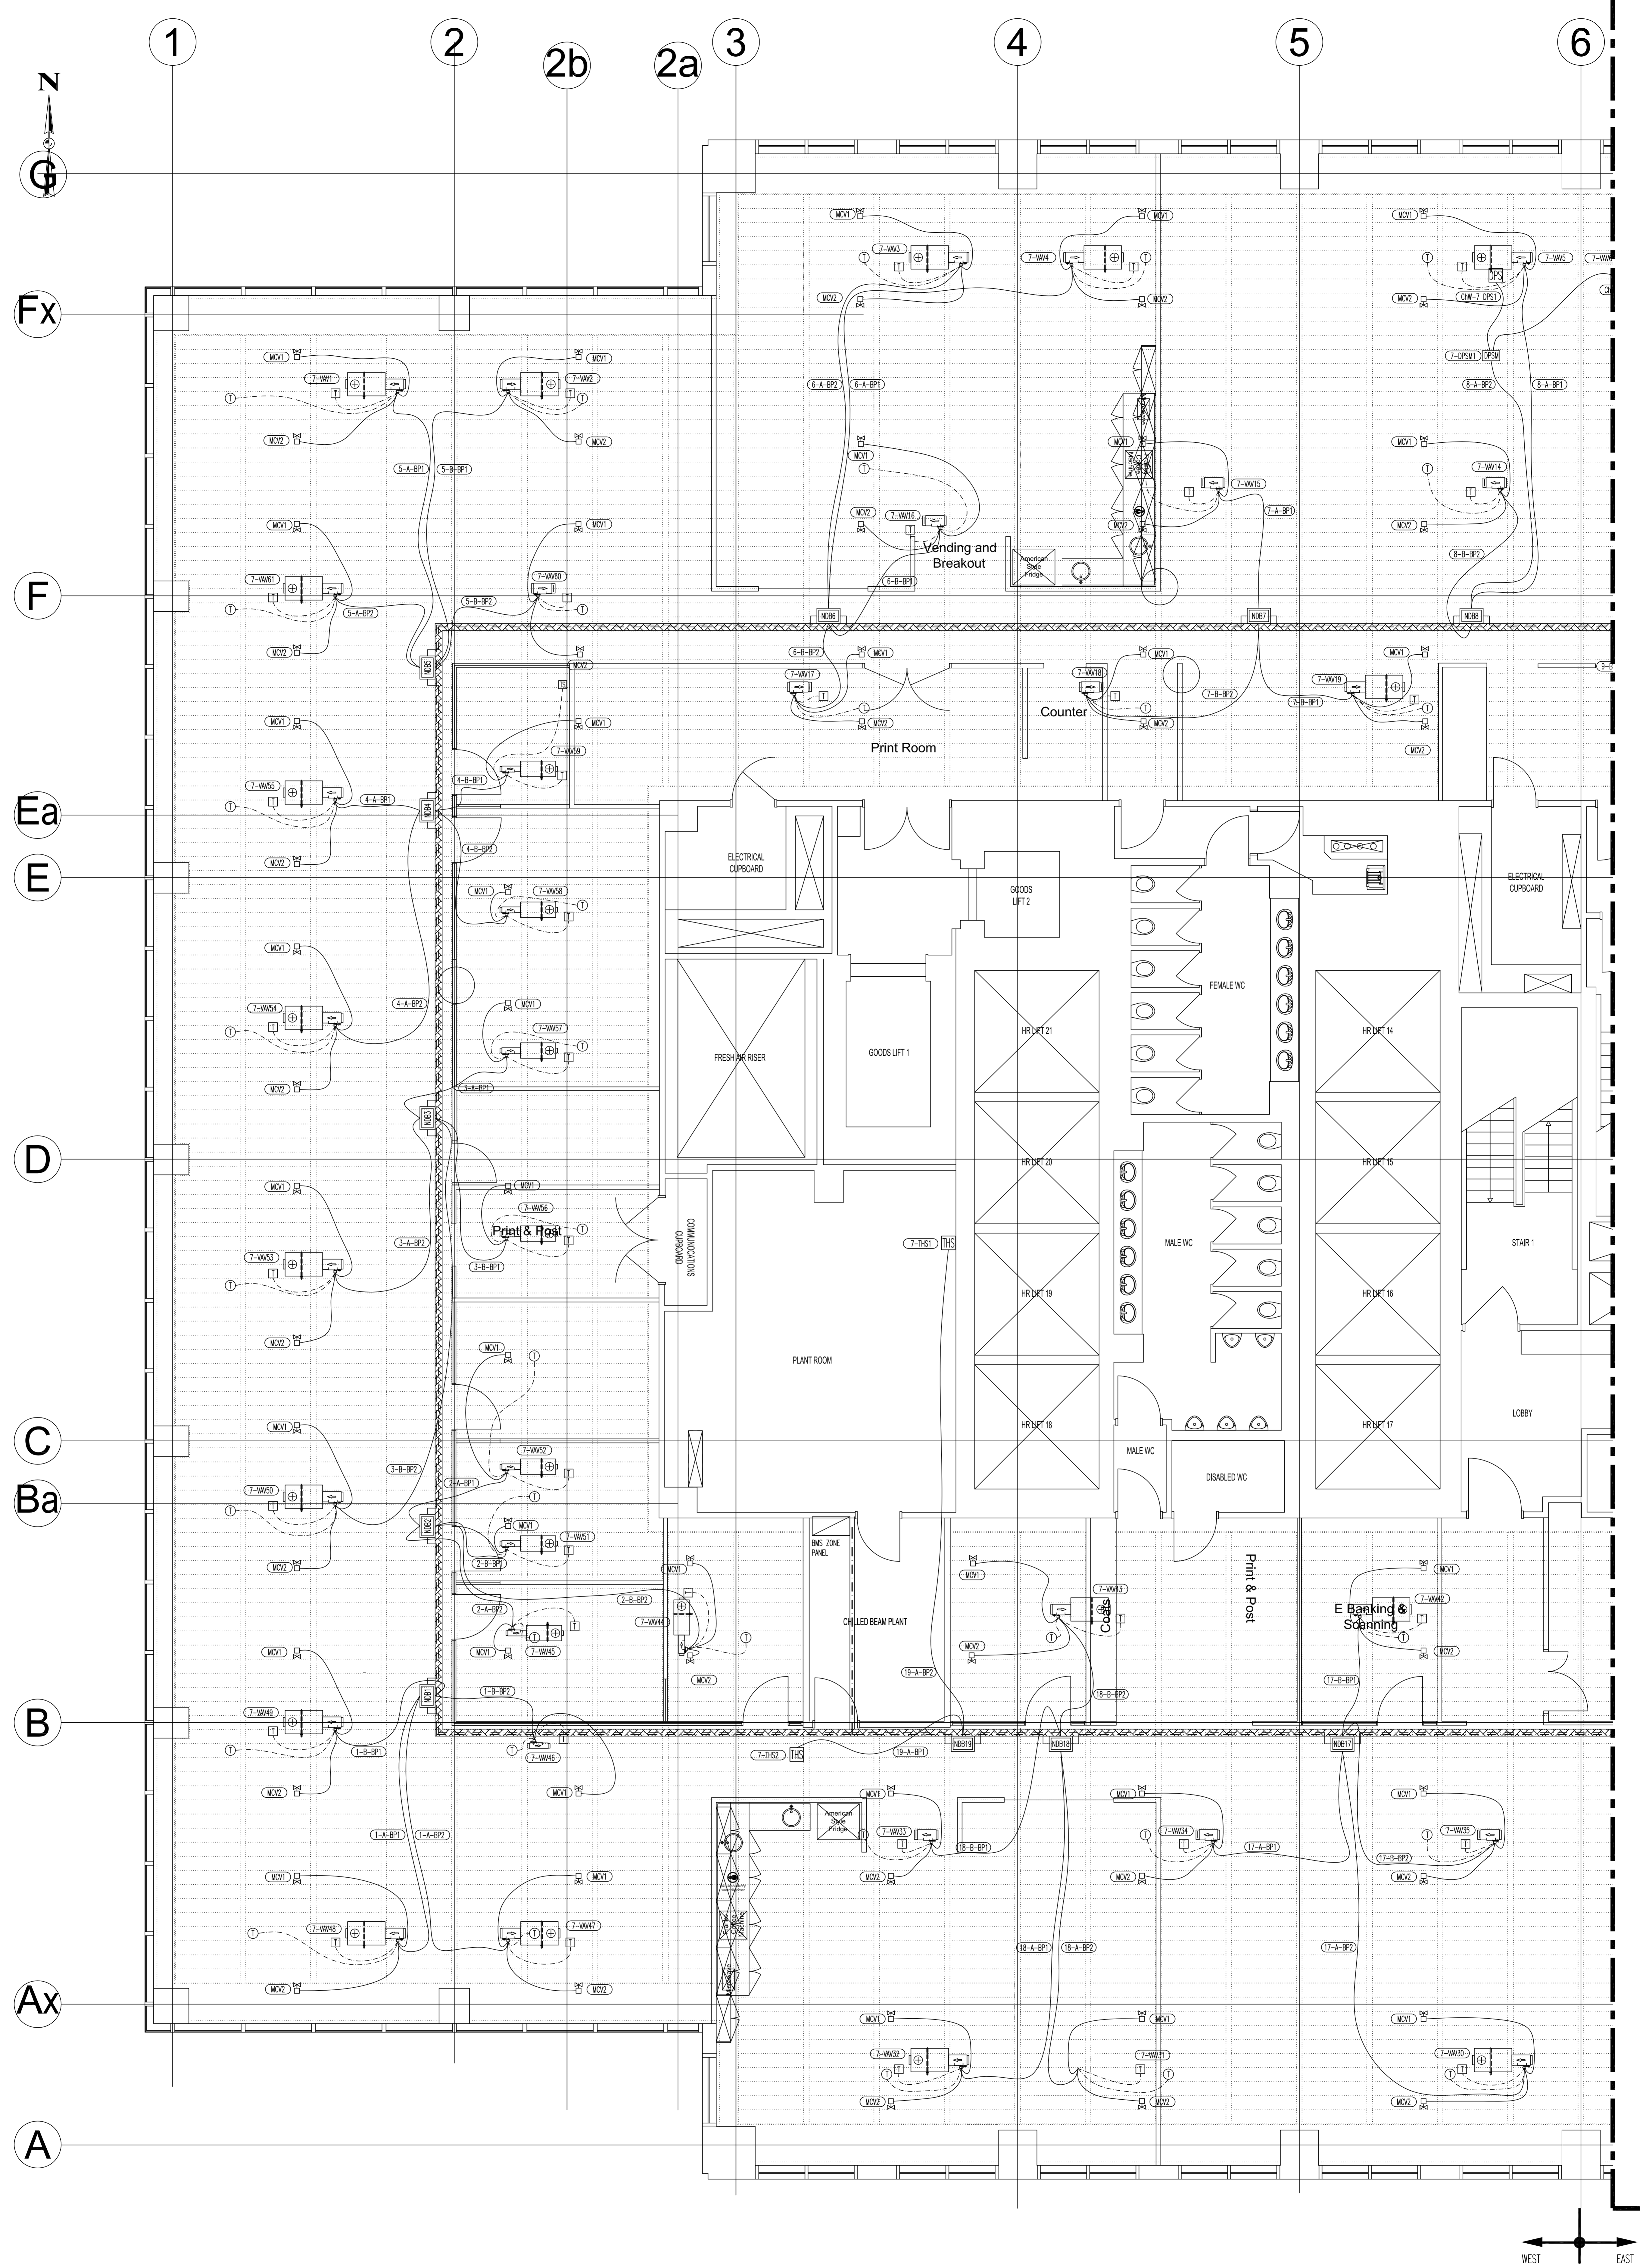

FOR CONTINUATION
REFER TO DRAWING
2092-7-C200

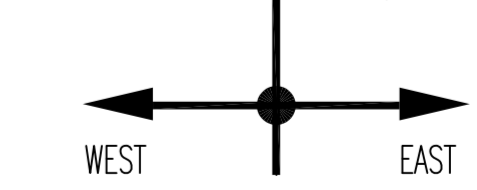

TITLE: HIGH LEVEL HVAC CONTROLS 7th FLOOR WEST		RECORD DRAWING		REV.	DATE	DESCRIPTION	DRN.	CHKD.
CONSULTANT: PRINCIPAL CONTRACTOR: CONTRACT:		LEVEL 7 BLOCK PLAN 						
LOGO HERE ADDRESS HERE		KEY TO SYMBOLS: NDB NETWORK DISTRIBUTION BOXES (Floor Qty=19) --- INTERCONNECTING BUSWY LEADS AT HIGH LEVEL --- INTERCONNECTING BUSWY LEADS AT LOW LEVEL --- NETWORK & POWER CABLE --- NETWORK CABLE ONLY --- CONTROL --- SOFTWARE LINK WM WATER METER TMS TEMPERATURE/HUMIDITY SENSOR (Floor Qty=2) TTS WALL MOUNTED TEMPERATURE SENSOR TDT DUCT MOUNTED SUPPLY TEMP SENSOR (Floor Qty=54) TAT AIR TEMP SENSOR LOCATED IN CEILING SPACE (Floor Qty=54) MV MOTORISED VALVES (Floor Qty=111) EH ELECTRIC HEATER XX-XX-X NETWORK REFERENCE CHAN (NETWORK No.) NETWORK CABLE TYPE FLOOR REFERENCE XX-XXXXX CONTROLS REFERENCE DEVICE REFERENCE FLOOR REFERENCE XX-C-XXX NDB NETWORK REFERENCE PORT NO. CONNECTION TYPE --- SP = BUS & POWER CHANNEL A OR B A OR B = BUS ONLY NDB NUMBER						
DRG No. CW2896C-7-C100-RD-A DRAWN JS DATE 20/06/2011 SCALE 1:50 CHKD. NB APP. NB		REFERENCE DRAWINGS:						